

IMPORTANT NOTES:
 (These notes are an integral part of this plan)
 This plan was prepared as part of the on-going construction process for this project.
 This plan is an internal company working drawing and the information shown hereon is subject to continual amendments and updating without notice.
 The dimensions, areas and total number of lots shown hereon are subject to field survey and preparation of final plans of survey.
 Marking of boundaries shown on this drawing may only be carried out by a surveyor licensed under the Surveyors Act 1977.
 No reliance should be placed on the information on this plan for any dealings without prior confirmation in writing from THGWSG Pty Ltd, who accept no responsibility for any unauthorised use of this plan.
 Copyright © THGWSG December 2013

THESE DESIGNS AND DRAWINGS ARE COPYRIGHTED AND ARE NOT TO BE USED OR REPRODUCED WITHOUT THE WRITTEN PERMISSION OF THG

- Data Sources:
- Cadastral Boundaries *
 - Contours / Topographic *
 - Aerial Images *
 - Flood Level *
 - Engineering Design *
 - Architectural Design *
 - Landscape Design *

No	Revisions	Date	Chkd
C	Updated Construction	04-01-16	RP
B	Updated Construction	25-11-15	RP
A	Updated Construction	10-09-15	RP

Parish: GOODNA
 County: STANLEY
 Locality: BELLBIRD PARK
 Local Authority: ICC
 Map Reference: 9442-12443
 Title Reference: VARIOUS
 Horizontal Meridian: MGA
 Vertical Level Datum: AHD Der
 Level Origin: EXISTING SITE
 Scale: 1:250 @ A1
 Surveyed: RP
 Designed: HYDER
 Drawn: RP
 Checked: RP
 Plot Date: 14 Jan, 2016
 Computer File Ref: 30219 AC WATER 20-22 (C) 040116.dwg

AS BUILT
WATER RETICULATION
PROGRESS PLOT
STAGES 20-22
BRENTWOOD ESTATE
 Sheet 1 of 5



BRISBANE (07) 3666 4700 MACKAY (07) 4951 2911 PROSERPINE (07) 4945 1722
 BOWEN (07) 4786 1050 CAIRNS (07) 4051 6722

Email: mail@thg.com.au www.thg.com.au
 Queensland Surveying Pty Ltd t/a THG Resource Strategists

Drawing No: 30219-AC-20W Issue: C



This Plan is an Internal Working Drawing Reflecting the Progress of Construction and a Record of As-Built Survey Pick Up. The Final Record of As Built Infrastructure is Represented in the Local Authority As Built Data Submission which is Provided on Full Completion of Construction.



12.5m 50mm 25m 100mm 37.5m 150mm SCALE BAR


SEE SHEET 3

SEE SHEET 4

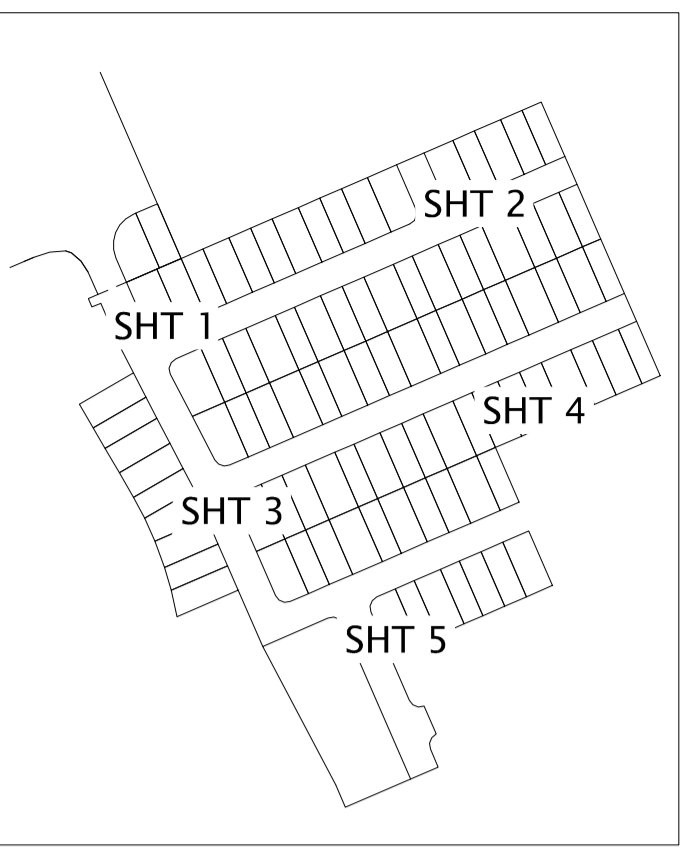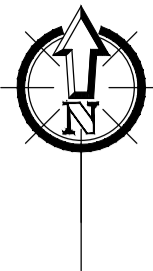

SEE SHEET 1

SEE SHEET 4

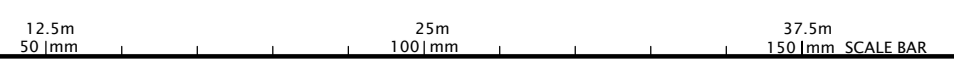

IMPORTANT NOTES:
 (These notes are an integral part of this plan)
 This plan was prepared as part of the on-going construction process for this project.
 This plan is an internal company working drawing and the information shown hereon is subject to continual amendments and updating without notice.
 The dimensions, areas and total number of lots shown hereon are subject to field survey and preparation of final plans of survey.
 Marking of boundaries shown on this drawing may only be carried out by a surveyor licensed under the Surveyors Act 1977.
 No reliance should be placed on the information on this plan for any dealings without prior confirmation in writing from THGWSG Pty Ltd, who accept no responsibility for any unauthorised use of this plan.
 Copyright © THGWSG December 2013

THESE DESIGNS AND DRAWINGS ARE COPYRIGHTED AND ARE NOT TO BE USED OR REPRODUCED WITHOUT THE WRITTEN PERMISSION OF THG

Data Sources:
 Cadastral Boundaries *
 Contours / Topographic *
 Aerial Images *
 Flood Level *
 Engineering Design *
 Architectural Design *
 Landscape Design *

No	Revisions	Date	Chkd
C	Updated Construction	04-01-16	RP
B	Updated Construction	25-11-15	RP
A	Updated Construction	10-09-15	RP

Parish: GOODNA
 County: STANLEY
 Locality: BELLBIRD PARK
 Local Authority: ICC
 Map Reference: 9442-12443
 Title Reference: VARIOUS
 Horizontal Meridian: MGA
 Vertical Level Datum: AHD Der
 Level Origin: EXISTING SITE
 Scale: 1:250 @ A1
 Surveyed: RP
 Designed: HYDER
 Drawn: RP
 Checked: RP
 Plot Date: 14 Jan, 2016
 Computer File Ref: 30219 AC WATER 20-22 (C) 040116.dwg

AS BUILT
WATER RETICULATION
PROGRESS PLOT
STAGES 20-22
BRENTWOOD ESTATE
 Sheet 1 of 5




BRISBANE (07) 3666 4700
 MACKAY (07) 4951 2911
 PROSERPINE (07) 4945 1722
 BOWEN (07) 4786 1050
 CAIRNS (07) 4051 6722

Email mail@thg.com.au www.thg.com.au
 Queensland Surveying Pty Ltd t/a THG Resource Strategists

Drawing No: 30219-AC-20W
 Issue: C

This Plan is an Internal Working Drawing Reflecting the Progress of Construction and a Record of As-Built Survey Pick Up. The Final Record of As Built Infrastructure is Represented in the Local Authority As Built Data Submission which is Provided on Full Completion of Construction.

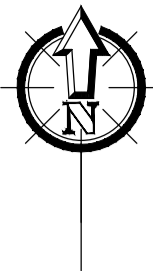

SEE SHEET 1


MEADOWS
CIRCUIT



SEE SHEET 4

SEE SHEET 4

SEE SHEET 5

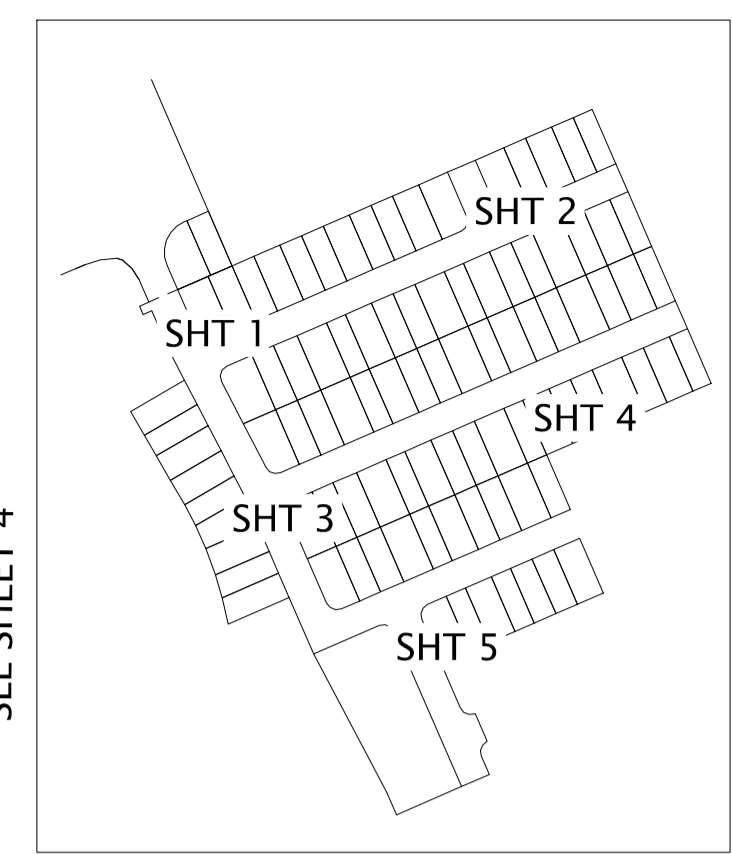

IMPORTANT NOTES:
 (These notes are an integral part of this plan)
 This plan was prepared as part of the on-going construction process for this project.
 This plan is an internal company working drawing and the information shown hereon is subject to continual amendments and updating without notice.
 The dimensions, areas and total number of lots shown hereon are subject to field survey and preparation of final plans of survey.
 Marking of boundaries shown on this drawing may only be carried out by a surveyor licensed under the Surveyors Act 1977.
 No reliance should be placed on the information on this plan for any dealings without prior confirmation in writing from THGWSG Pty Ltd, who accept no responsibility for any unauthorised use of this plan.
 Copyright © THGWSG December 2013

THESE DESIGNS AND DRAWINGS ARE COPYRIGHTED AND ARE NOT TO BE USED OR REPRODUCED WITHOUT THE WRITTEN PERMISSION OF THG

- Data Sources:
- * Cadastral Boundaries
 - * Contours / Topographic
 - * Aerial Images
 - * Flood Level
 - * Engineering Design
 - * Architectural Design
 - * Landscape Design

No	Revisions	Date	Chkd
C	Updated Construction	04-01-16	RP
B	Updated Construction	25-11-15	RP
A	Updated Construction	10-09-15	RP

Parish: GOODNA
 County: STANLEY
 Locality: BELLBIRD PARK
 Local Authority: ICC
 Map Reference : 9442-12443
 Title Reference : VARIOUS
 Horizontal Meridian: MGA
 Vertical Level Datum: AHD Der
 Level Origin: EXISTING SITE
 Scale: 1:250 @ A1
 Surveyed: RP
 Designed: HYDER
 Drawn: RP
 Checked: RP
 Plot Date: 14 Jan, 2016
 Computer File Ref: 30219 AC WATER 20-22 (C) 040116.dwg

**AS BUILT
 WATER RETICULATION
 PROGRESS PLOT
 STAGES 20-22
 BRENTWOOD ESTATE
 Sheet 1 of 5**




BRISBANE (07) 3666 4700
 MACKAY (07) 4951 2911
 PROSERPINE (07) 4945 1722
 BOWEN (07) 4786 1050
 CAIRNS (07) 4051 6722

Email mail@thg.com.au www.thg.com.au


Queensland Surveying Pty Ltd t/a THG Resource Strategists
 Drawing No 30219-AC-20W Issue C

This Plan is an Internal Working Drawing Reflecting the Progress of Construction and a Record of As-Built Survey Pick Up. The Final Record of As Built Infrastructure is Represented in the Local Authority As Built Data Submission which is Provided on Full Completion of Construction.

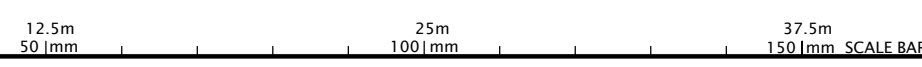



SEE SHEET 2

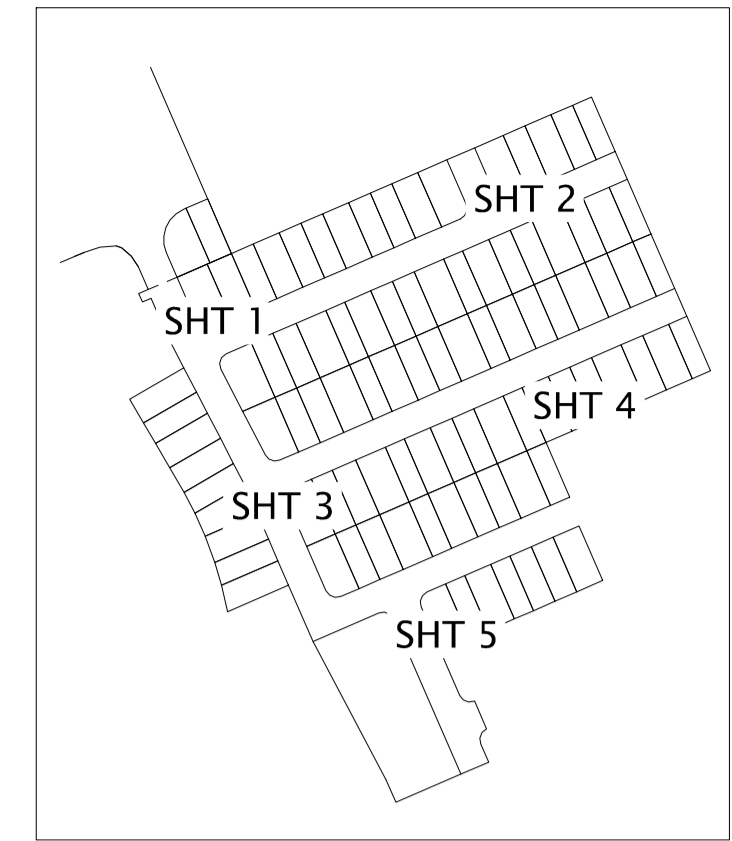

IMPORTANT NOTES:
 (These notes are an integral part of this plan)
 This plan was prepared as part of the on-going construction process for this project.
 This plan is an internal company working drawing and the information shown hereon is subject to continual amendments and updating without notice.
 The dimensions, areas and total number of lots shown hereon are subject to field survey and preparation of final plans of survey.
 Marking of boundaries shown on this drawing may only be carried out by a surveyor licensed under the Surveyors Act 1977.
 No reliance should be placed on the information on this plan for any dealings without prior confirmation in writing from THGWSG Pty Ltd, who accept no responsibility for any unauthorised use of this plan.
 Copyright © THGWSG December 2013

THESE DESIGNS AND DRAWINGS ARE COPYRIGHTED AND ARE NOT TO BE USED OR REPRODUCED WITHOUT THE WRITTEN PERMISSION OF THG

Data Sources	
Cadastral Boundaries	*
Contours / Topographic	*
Aerial Images	*
Flood Level	*
Engineering Design	*
Architectural Design	*
Landscape Design	*

C	Updated Construction	04-01-16	RP
B	Updated Construction	25-11-15	RP
A	Updated Construction	10-09-15	RP

No	Revisions	Date	Chkd

Parish: GOODNA
 County: STANLEY
 Locality: BELLBIRD PARK
 Local Authority: ICC
 Map Reference: 9442-12443
 Title Reference: VARIOUS
 Horizontal Meridian: MGA
 Vertical Level Datum: AHD Der
 Level Origin: EXISTING SITE
 Scale: 1:250 @ A1
 Surveyed: RP
 Designed: HYDER
 Drawn: RP
 Checked: RP
 Plot Date: 14 Jan, 2016
 Computer File Ref: 30219-AC-WATER-20-22 (C) 040116.dwg


**AS BUILT
 WATER RETICULATION
 PROGRESS PLOT
 STAGES 20-22
 BRENTWOOD ESTATE
 Sheet 1 of 5**



BRISBANE (07) 3666 4700 MACKAY (07) 4951 2911 PROSERPINE (07) 4945 1722
 BOWEN (07) 4786 1050 CAIRNS (07) 4051 6722
 Email: mail@thg.com.au www.thg.com.au
 Queensland Surveying Pty Ltd t/a THG Resource Strategists

Drawing No: 30219-AC-20W Issue: C



This Plan is an Internal Working Drawing Reflecting the Progress of Construction and a Record of As-Built Survey Pick Up. The Final Record of As Built Infrastructure is Represented in the Local Authority As Built Data Submission which is Provided on Full Completion of Construction.

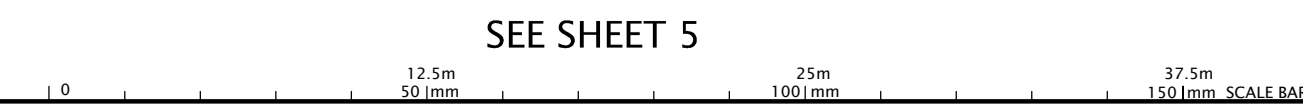

SEE SHEET 5



E HYDRANT
E 100

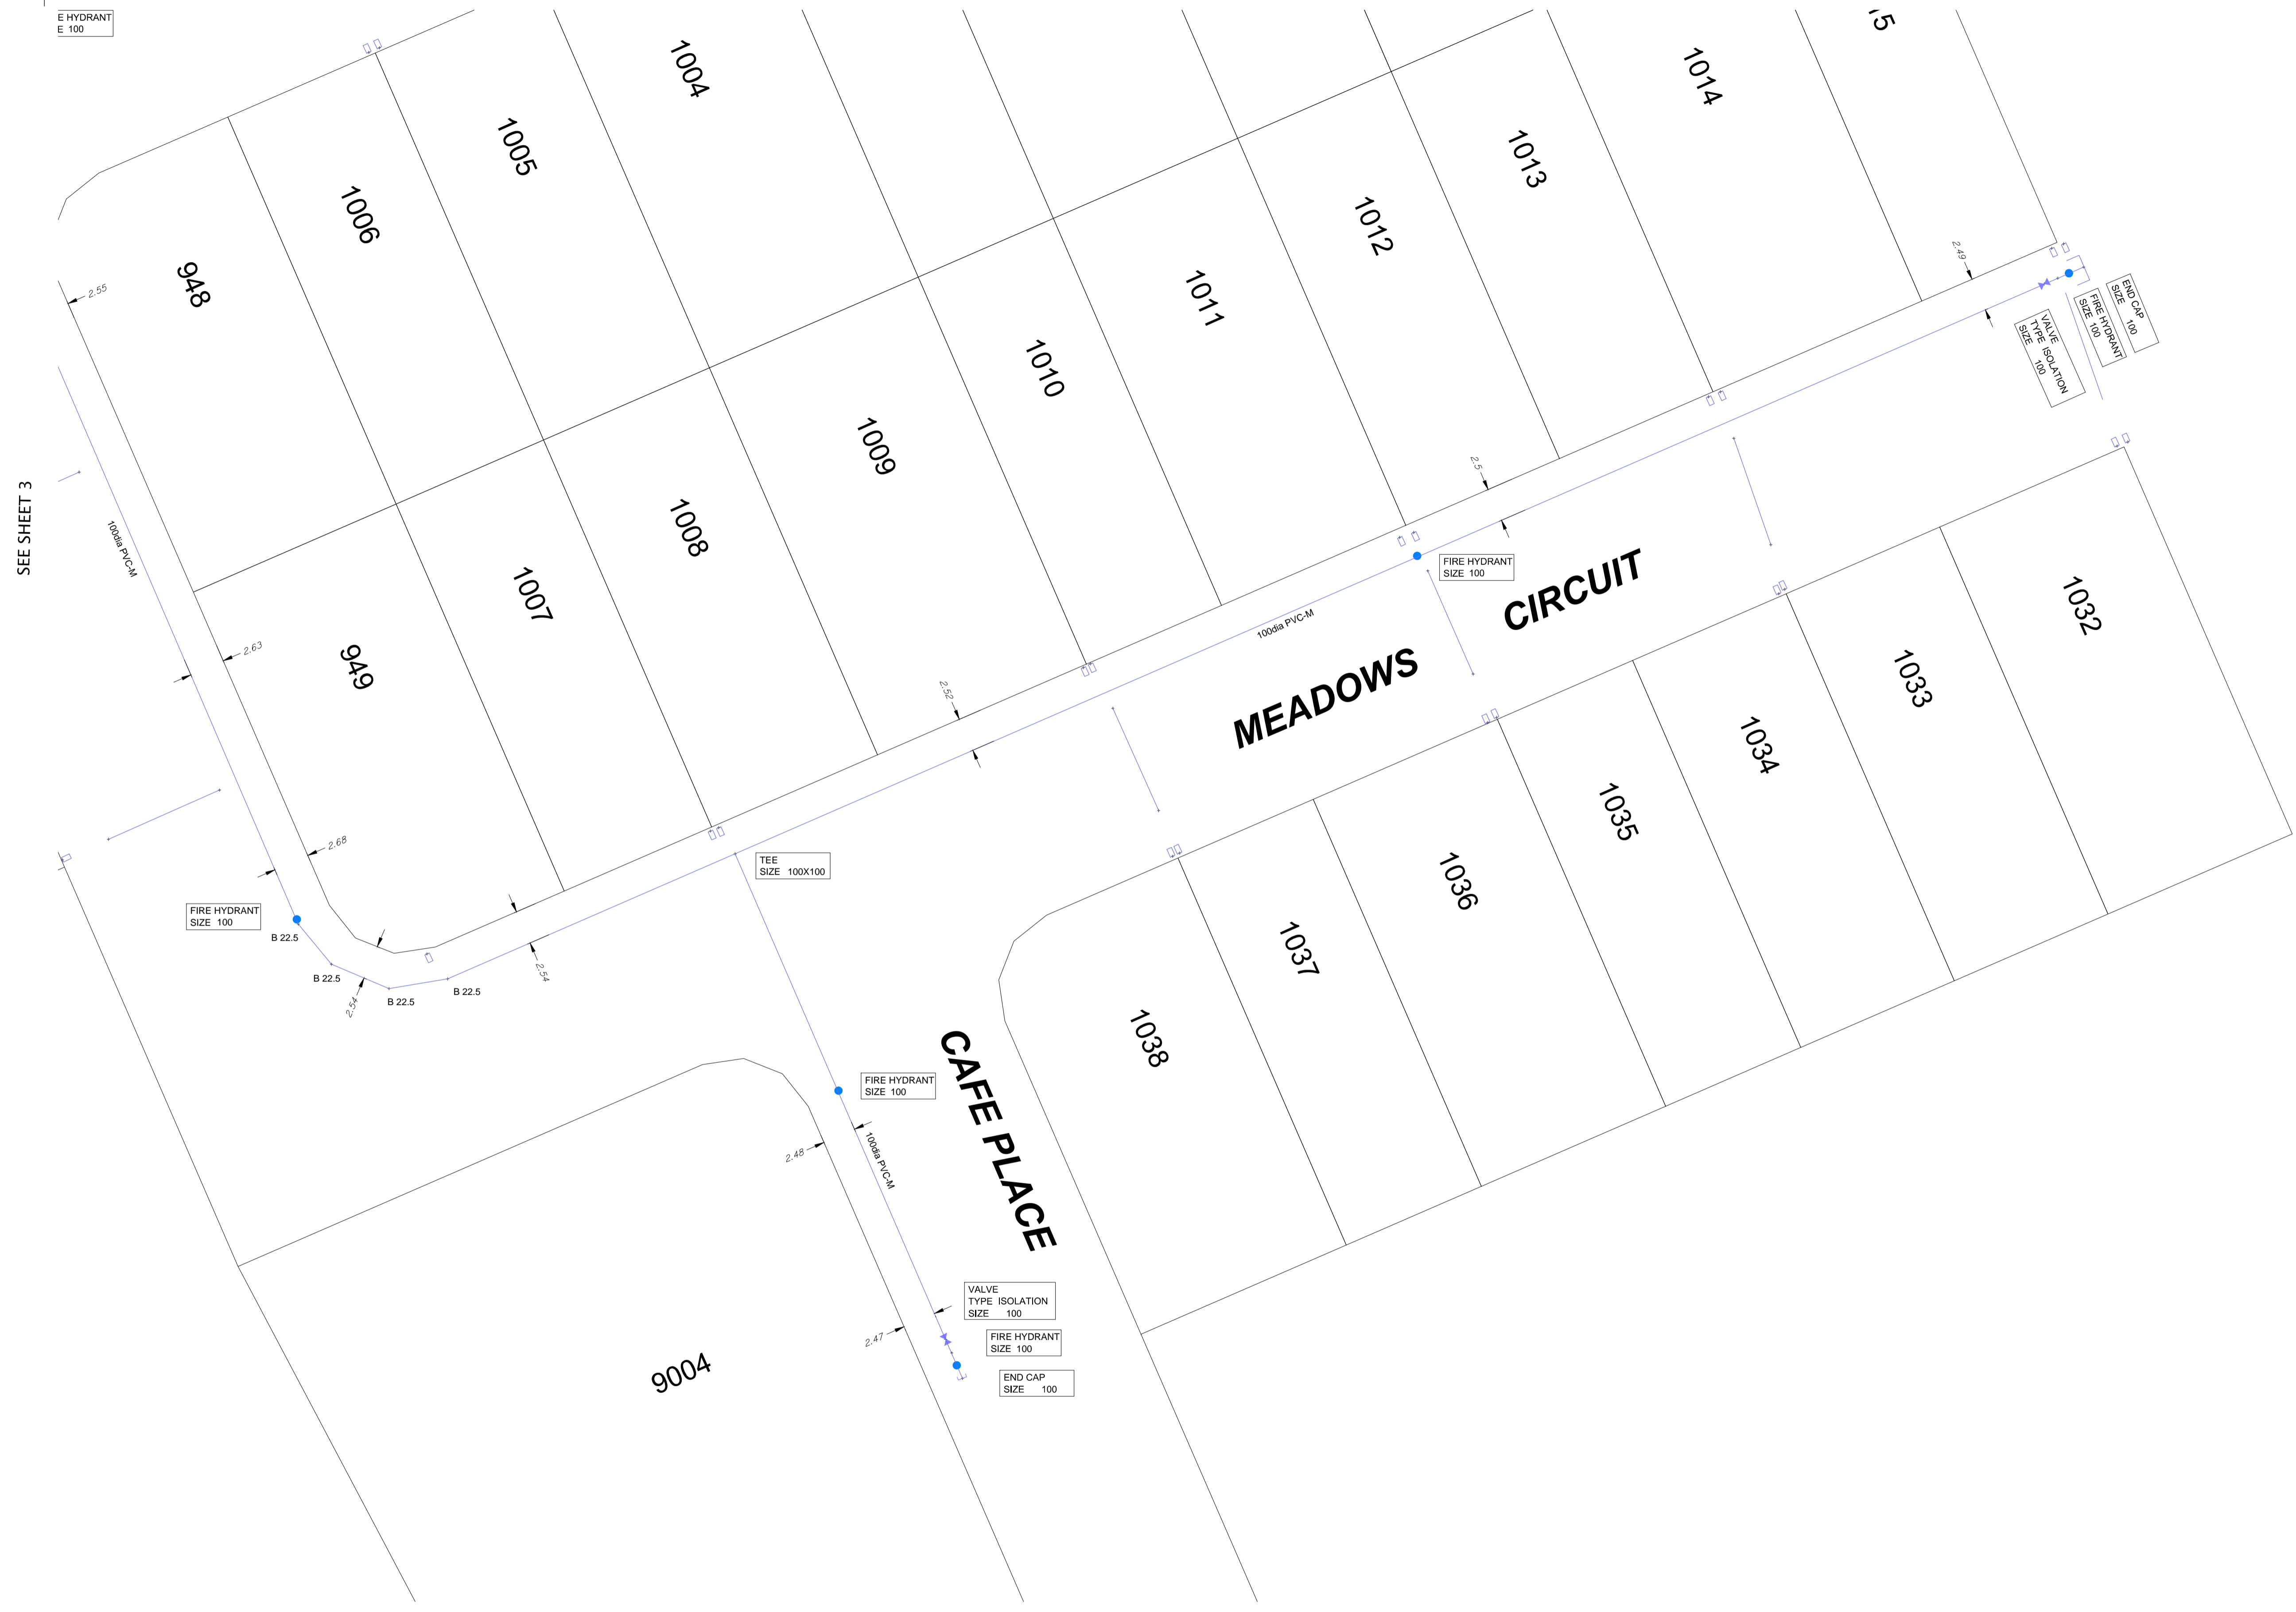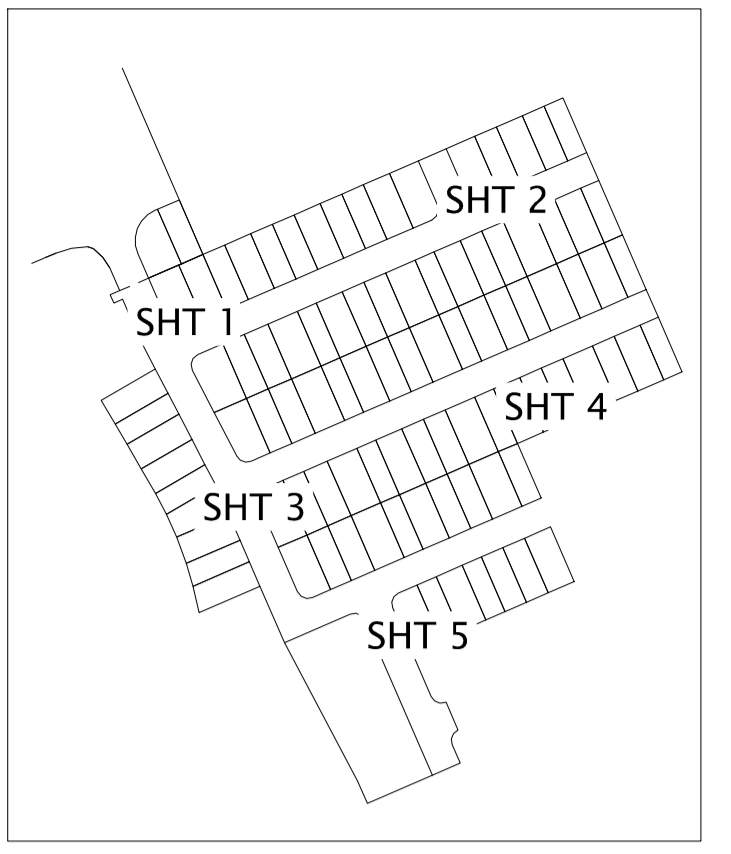

SEE SHEET 3

IMPORTANT NOTES:
 (These notes are an integral part of this plan)
 This plan was prepared as part of the on-going construction process for this project.
 This plan is an internal company working drawing and the information shown hereon is subject to continual amendments and updating without notice.
 The dimensions, areas and total number of lots shown hereon are subject to field survey and preparation of final plans of survey.
 Marking of boundaries shown on this drawing may only be carried out by a surveyor licensed under the Surveyors Act 1977.
 No reliance should be placed on the information on this plan for any dealings without prior confirmation in writing from THGWSG Pty Ltd, who accept no responsibility for any unauthorised use of this plan.
 Copyright © THGWSG December 2013

THESE DESIGNS AND DRAWINGS ARE COPYRIGHTED AND ARE NOT TO BE USED OR REPRODUCED WITHOUT THE WRITTEN PERMISSION OF THG

No	Revisions	Date	Chkd
C	Updated Construction	04-01-16	RP
B	Updated Construction	25-11-15	RP
A	Updated Construction	10-09-15	RP

Parish: GOODNA
 County: STANLEY
 Locality: BELLBIRD PARK
 Local Authority: ICC
 Map Reference: 9442-12443
 Title Reference: VARIOUS
 Horizontal Meridian: MGA
 Vertical Level Datum: AHD Der
 Level Origin: EXISTING SITE
 Scale: 1:250 @ A1
 Surveyed: RP
 Designed: HYDER
 Drawn: RP
 Checked: RP
 Plot Date: 14 Jan, 2016
 Computer File Ref: 30219 AC WATER 20-22 (C) 040116.dwg

**AS BUILT
 WATER RETICULATION
 PROGRESS PLOT
 STAGES 20-22
 BRENTWOOD ESTATE
 Sheet 1 of 5**



BRISBANE (07) 3666 4700
 MACKAY (07) 4951 2911
 PROSERPINE (07) 4945 1722
 BOWEN (07) 4786 1050
 CAIRNS (07) 4051 6722

Email mail@thg.com.au www.thg.com.au
Queensland Surveying Pty Ltd t/a THG Resource Strategists

Drawing No 30219-AC-20W Issue C

This Plan is an Internal Working Drawing Reflecting the Progress of Construction and a Record of As-Built Survey Pick Up. The Final Record of As Built Infrastructure is Represented in the Local Authority As Built Data Submission which is Provided on Full Completion of Construction.

